

92-210

CITY OF HAILEY

FLOODPLAIN DEVELOPMENT PERMIT

Name of Applicant Rod Gilga Date 10/11/90
Name of Project if applicable _____
Address 1641 NORTHRIDGE DR. Phone _____
Location of Proposed Development Subdivision Northridge Lot 18
Block 4 Plat _____

Description of Development

- | | | |
|--|--|--|
| <input checked="" type="checkbox"/> Residential Construction On Single Lot | <input type="checkbox"/> Non-Residential Subdivision | <input checked="" type="checkbox"/> New Construction |
| <input type="checkbox"/> Addition or Improvements | <input type="checkbox"/> Fill | <input type="checkbox"/> Excavation |
| <input type="checkbox"/> Watercourse Alteration | | <input type="checkbox"/> Grading |
| <input type="checkbox"/> Other _____ | | |


Attach to the application the following information where applicable. Plans in duplicate, drawn to scale showing the nature, dimensions, and elevations of the area in question; existing or proposed structures, fill, storage of materials, drainage facilities; and the location of the foregoing. Specifically, the following information is required: (1) Mean sea level (MSL) elevation of the lowest floor (including basement) of all structures; (2) MSL elevation to which any structure is floodproofed; (3) certification by a registered professional engineer that the floodproofing methods meet the community floodproofing criteria; (4) a description of the extent to which any watercourse will be altered or relocated, and (5) base (100-year) flood elevation data for a development or subdivision.

The proposed development is located in the Floodway Floodfringe
The Base Flood Elevation or depth number at the development site is: 100
Source Documents 1' above NG

Plan Review

MSL Elevation or depth number to which the structure is to be elevated 101 ft.
MSL Elevation or depth number to which the structure is to be floodproofed _____ ft.

SIGNATURE [Signature]
NAME Richard F. Wenglikowski
TITLE Surveyor
ADDRESS Hailey, Ida

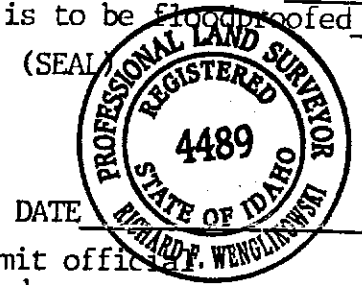

The following is to be completed by the community permit office. All necessary information and certificates are attached.

- Action
- The proposed development is not in conformance with applicable Floodplain Management Standards (explanation attached). Permit is denied.
 - The proposal is not in conformance with applicable Floodplain Management Standards (explanation attached) and the application is referred to the Board of Adjustment for variance action.
 - I have reviewed the plans and materials submitted in support of the proposed development and find them in compliance with applicable Floodplain Management Standards. Permit is approved.

Date 28 OCT 92 Signature [Signature]

Building construction documentation

The certified as-built MSL elevation of the lowest floor of the structure is _____ ft.
The certified as-built MSL floodproofed elevation of the structure is _____ ft.
Certificates of a registered professional engineer or land surveyor documenting these elevation are attached.

Certificate of Occupancy or Compliance Issued _____
Date _____ Signature _____

CITY OF HAILEY

FLOODPLAIN ELEVATION/FLOOD-PROOFING CERTIFICATION

This Certification must be signed and sealed by a registered professional engineer or ~~architect~~

1st Survey:

I hereby certify that the bench mark set on property identified as

T. _____ S. 7 _____ W, W.M., Section _____, Tax Lot

_____ is at an elevation of 100⁰ feet, NGVD (Mean Sea Level)

Subdivision Northridge

Lot 18 Block 4 Plat _____

Describe bench mark and its location: _____


NE corner Lot 18 found iron pin
1/2"

SIGNATURE *Richard F. Wenglikowski* SEAL
NAME Richard F Wenglikowski
TITLE Surveyor
ADDRESS Hailey Ida
DATE 10/11/90




This certification must be filed with the Hailey Building Department at the time of building permit application.

North
 Scale
 Horz. 1" = 40'
 Vert. 1" = 6'

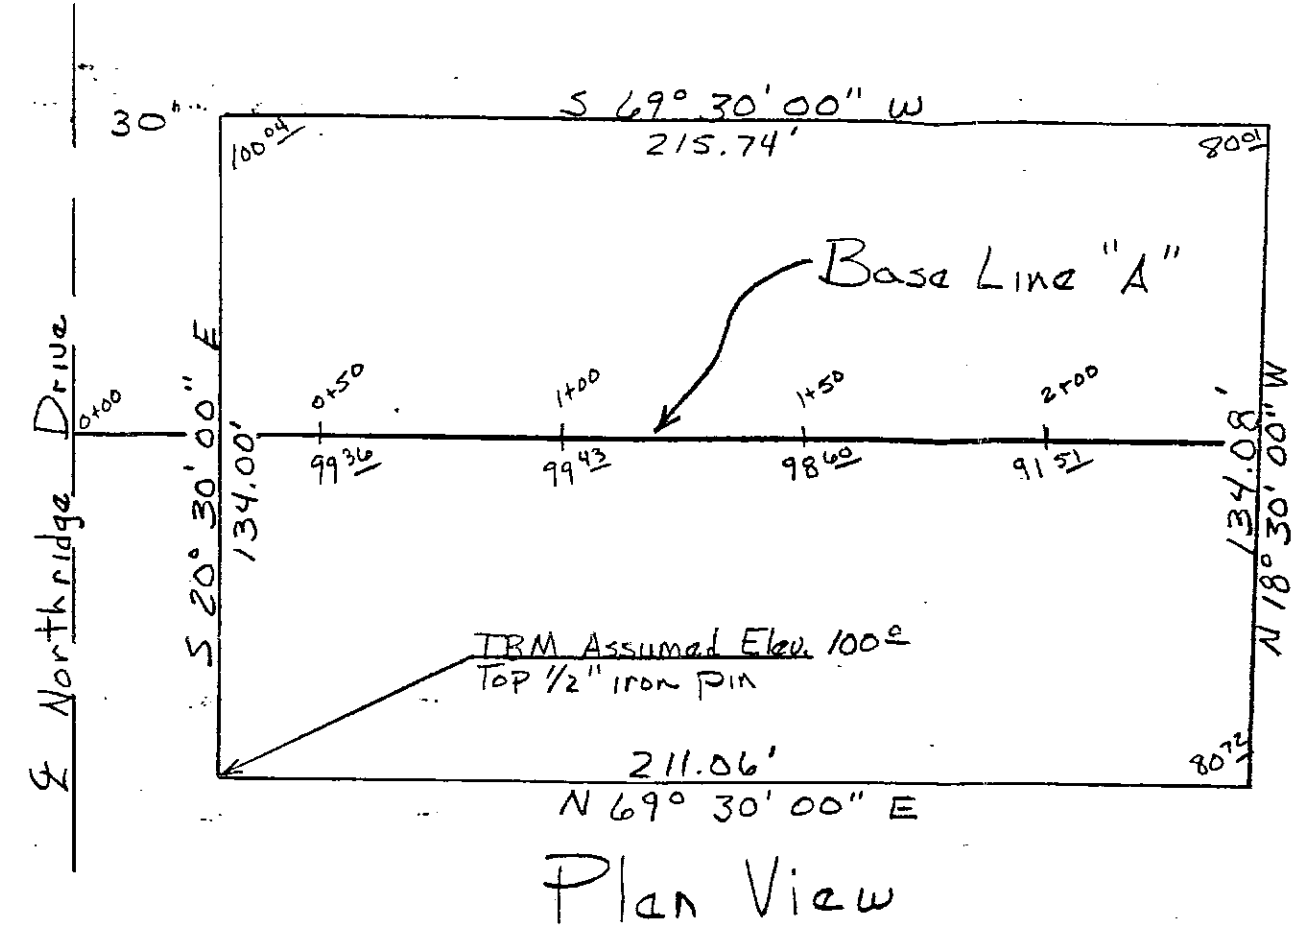

Plan View

Flood Certificate
 for
 Rod Gilge
 of
 Lot 18 B1K4 Northridge Sub.
 Hailey, Idaho
 10/11/90

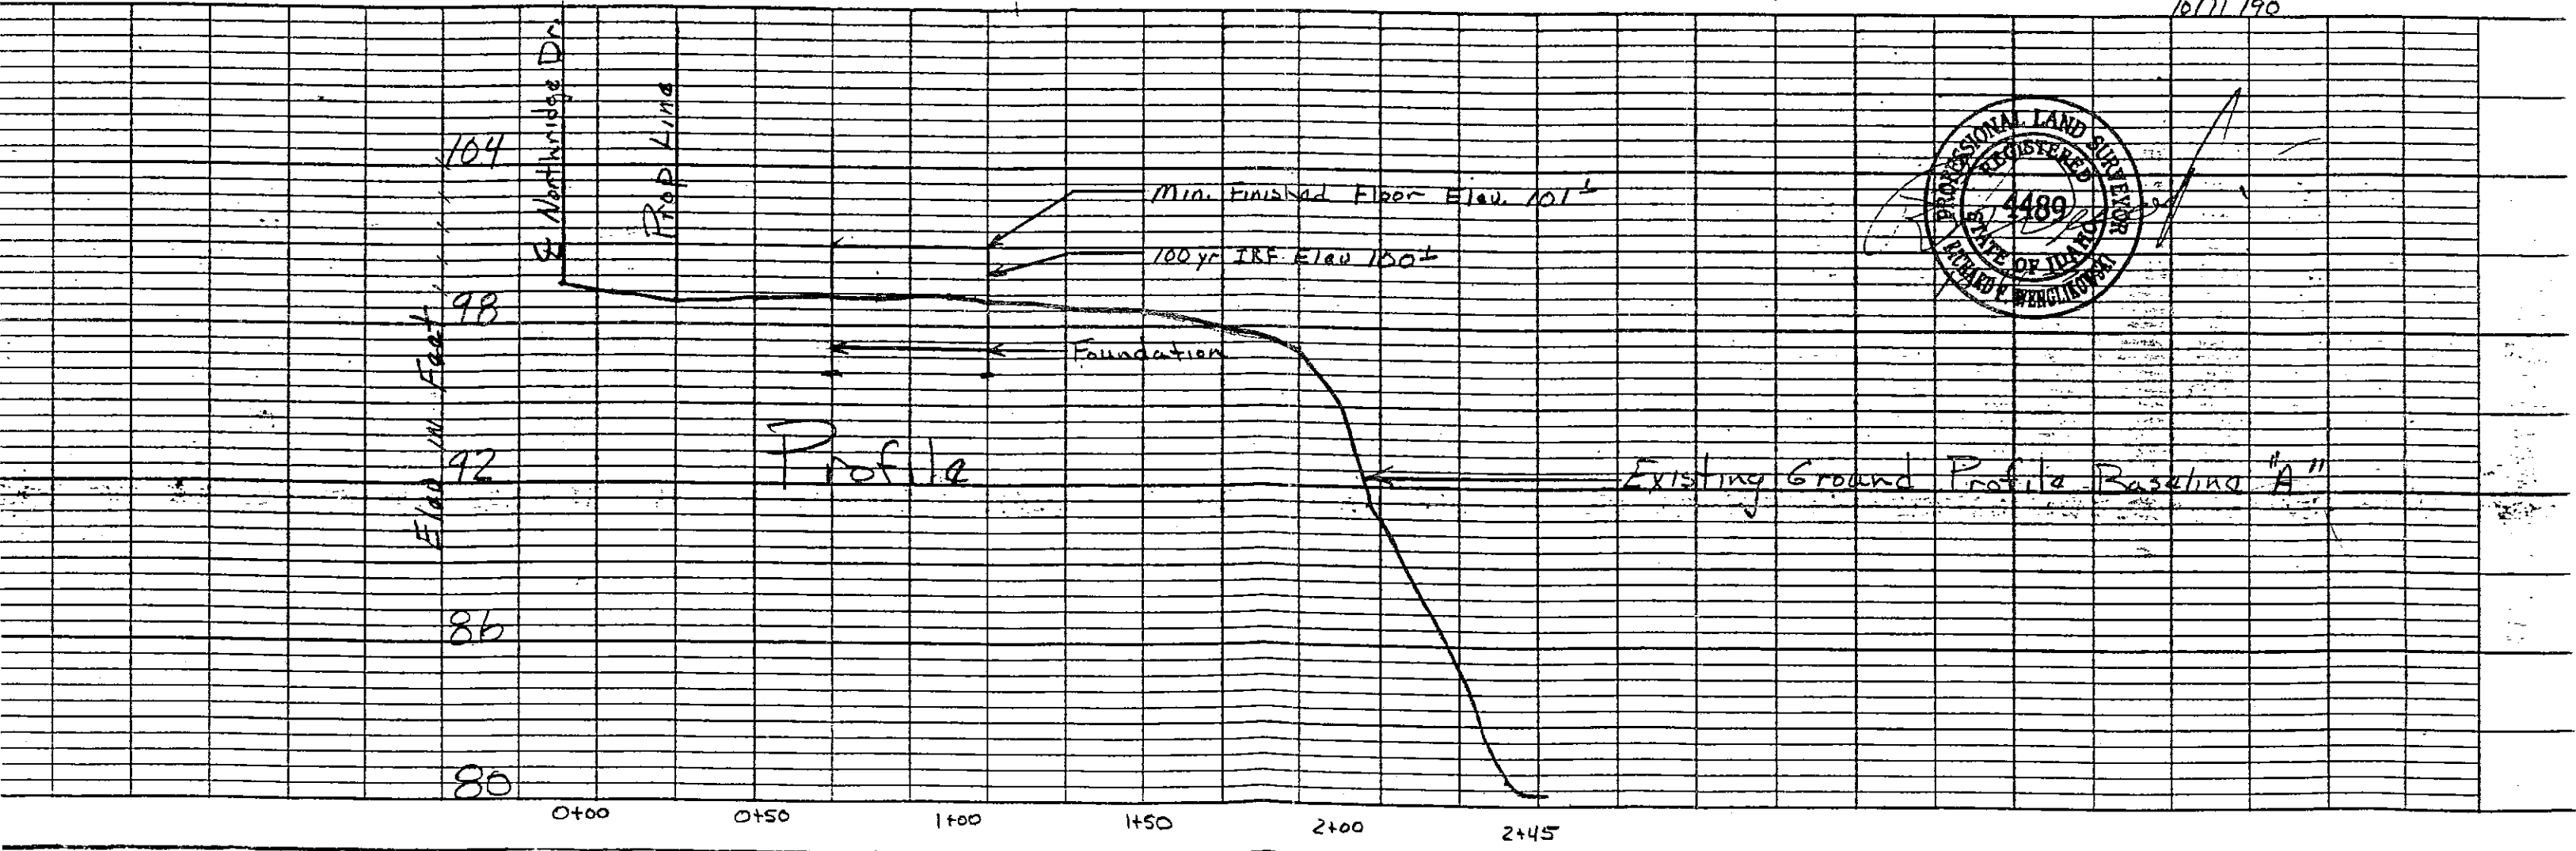

Profile

Existing Ground Profile Baseline "A"