

#87-38

FLOODPLAIN DEVELOPMENT PERMIT

Name of Applicant: Joe Yolda Date: 1-July-87
Address: P.O. Box 1882 Mailey Phone: 788-4131
Location of Proposed Development: Sherwood Forest

Description of Development

310 Robin Hood

- Residential Construction
 - New Construction
 - Addition or Improvements
 - Subdivision
 - Other
- Non-Residential
 - New Construction
 - Addition or Improvements
 - Fill
- Mobile Home
 - On Single Lot
 - In Mobile Home Park
 - Watercourse Alteration

Attach to the application the following information where applicable. Plans in duplicate, drawn to scale showing the nature, dimensions, and elevations of the area in question; existing or proposed structures, fill, storage of materials, drainage facilities; and the location of the foregoing. Specifically, the following information is required: (1) Mean Sea Level (MSL) elevation of the lowest floor (including basement) of all structures; (2) MSL elevation to which any structure is floodproofed; (3) certification by a registered professional engineer or architect that the floodproofing methods meet the community floodproofing criteria; (4) a description of the extent to which any watercourse will be altered or relocated, and (5) base (100-year) flood elevation data for a development or subdivision greater than 50 lots or 5 acres.

The following is to be completed by the Community Permit Official:

The proposed development is located in the Floodway Floodfringe
The Base Flood Elevation or depth number at the development site is:

Source Documents: National Flood Ins-Program-Parcel #16022000/C
APR 17-1978

Plan Review

MSL Elevation or depth number to which the structure is to be elevated: 5293³/₈ feet.
MSL Elevation or depth number to which the structure is to be floodproofed: _____ feet.

All necessary information and certificates are attached.

Action

- The proposed development is not in conformance with applicable Floodplain Management Standards (explanation attached). Permit is denied.
- The proposal is not in conformance with applicable Floodplain Management Standards (explanation attached) and the application is referred to the Board of Adjustment for variance action.
- I have reviewed the plans and materials submitted in support of the proposed development and find them in compliance with applicable Floodplain Management Standards. Permit is approved.

1-July-1987
Date

[Signature]
Signature

Building Construction Documentation

The certified as-built MSL elevation of the lowest floor of the structure is 5293³/₈ feet
The certified as-built MSL floodproofed elevation of the structure is N/A feet

Certificates of a registered professional engineer or land surveyor documenting these elevations are attached.

Certificate of Occupancy or Compliance Issued: 2-17-88
Date

[Signature]
Signature

CITY OF HAILEY

POST CONSTRUCTION ELEVATION CERTIFICATE

Community No. 160022

2nd Survey:

I M P O R T A N T

This form must be completed and returned to the City of Hailey Building Department prior to obtaining a framing inspection.

SECTION I

The elevation certification must be completed by a registered professional engineer or surveyor.

Property Description:

Subdivision Sherwood Forest Lot 11 Block 2 Plat _____

FIA Map Panel on which property is located _____

FIA Map Zone in which property is located _____

Base Flood Elevation at the proposed site 52925

Required minimum elevation of lowest floor 52935

NAME [Signature] DATE 7-10-87

ELEVATION CERTIFICATION

I certify that the building at the property location described above has the lowest floor at an elevation of 52935 feet, NGBD (mean Sea Level).

CERTIFIER'S NAME Bruce T. Butler AFFIX SEAL OR STAMP

TITLE Prof. Engineer / Land Surveyor

ADDRESS P.O. 478 Hailey

SIGNATURE [Signature]

DATE 7-10-87

L.S. # 907

CITY OF HAILEY

FLOODPLAIN ELEVATION/FLOOD-PROOFING CERTIFICATION

This Certification must be signed and sealed by a registered professional engineer or ~~architect~~

1st Survey:

I hereby certify that the bench mark set on property identified as

T. _____ S, R _____ W, W.M., Section _____, Tax Lot

_____ is at an elevation of 5293⁵ feet, NGVD (Mean Sea Level)

Subdivision Sherwood Forest Subd.

Lot 11 Block 2 Plat Sherwood Forest Subd.

Describe bench mark and its location: Spike set at

Finish Floor Eleo. 5293⁵ in 6" φ

Aspen near NW cor. Lot 11

1^o foot above 100-yr. Flood

SIGNATURE 


SEAL

NAME Bruce T. Butler


TITLE Engineer

ADDRESS P.O. 478


DATE 6-8-07

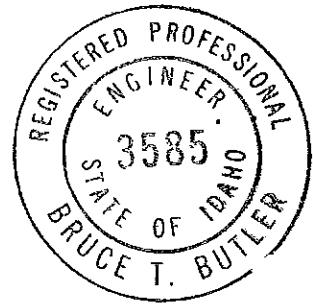


This certification must be filed with the Hailey Building Department at the time of building permit application.

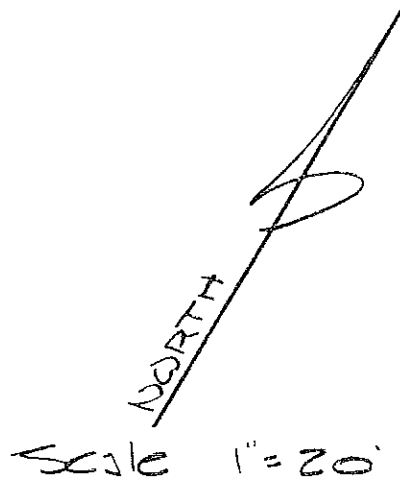


LOT 10

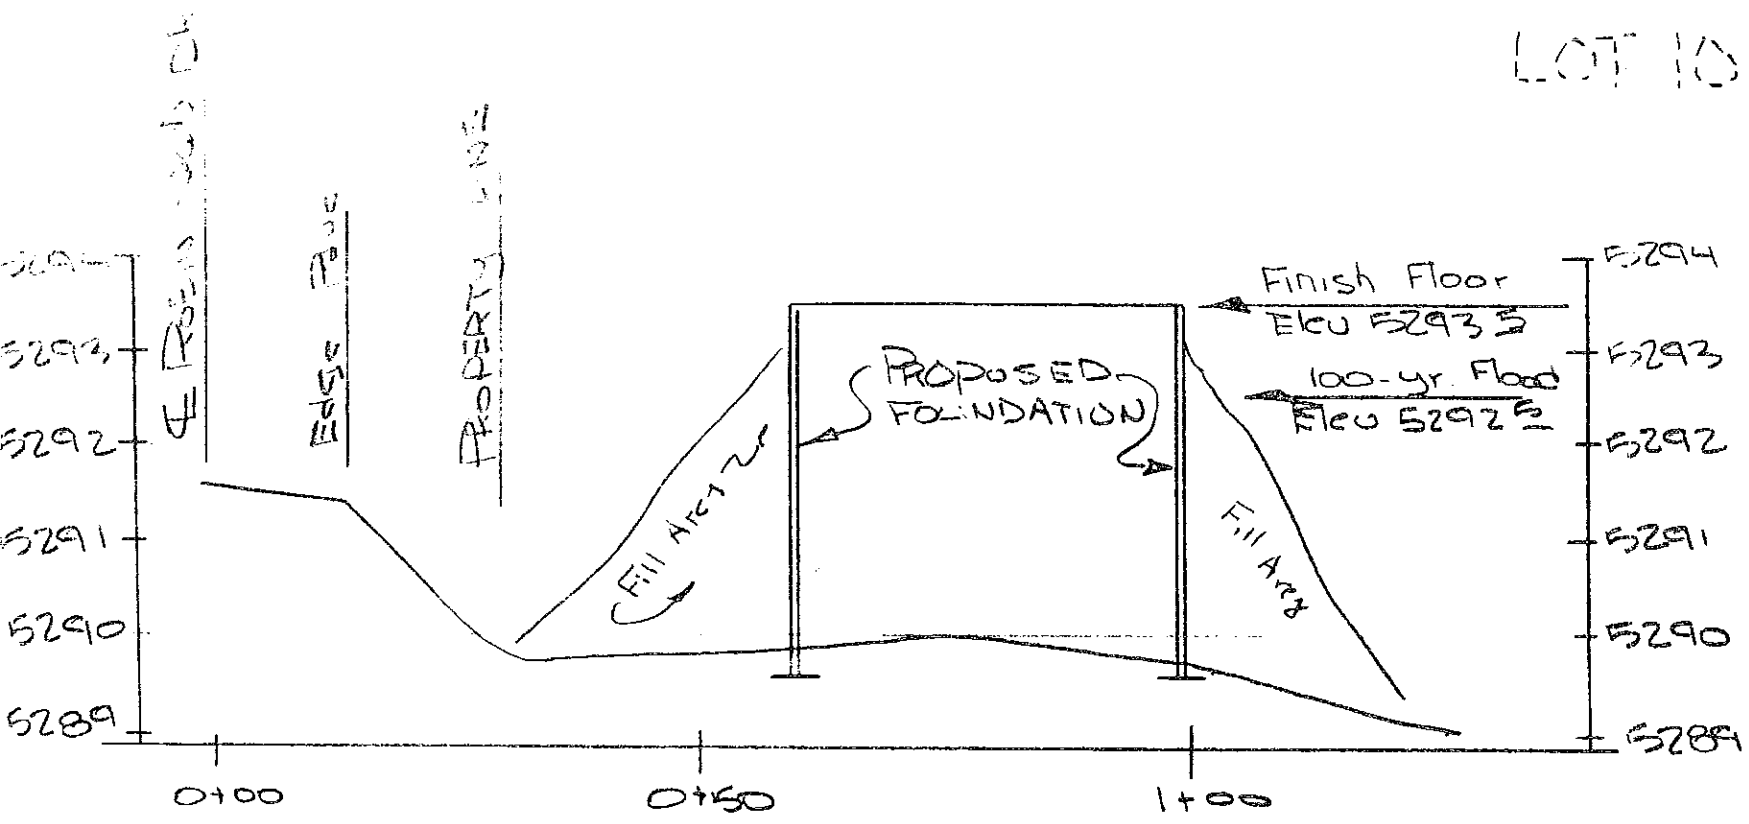

PROFILE LOT 11 BK 2
 Scale 1" = 20' HOR
 1" = 2' VER

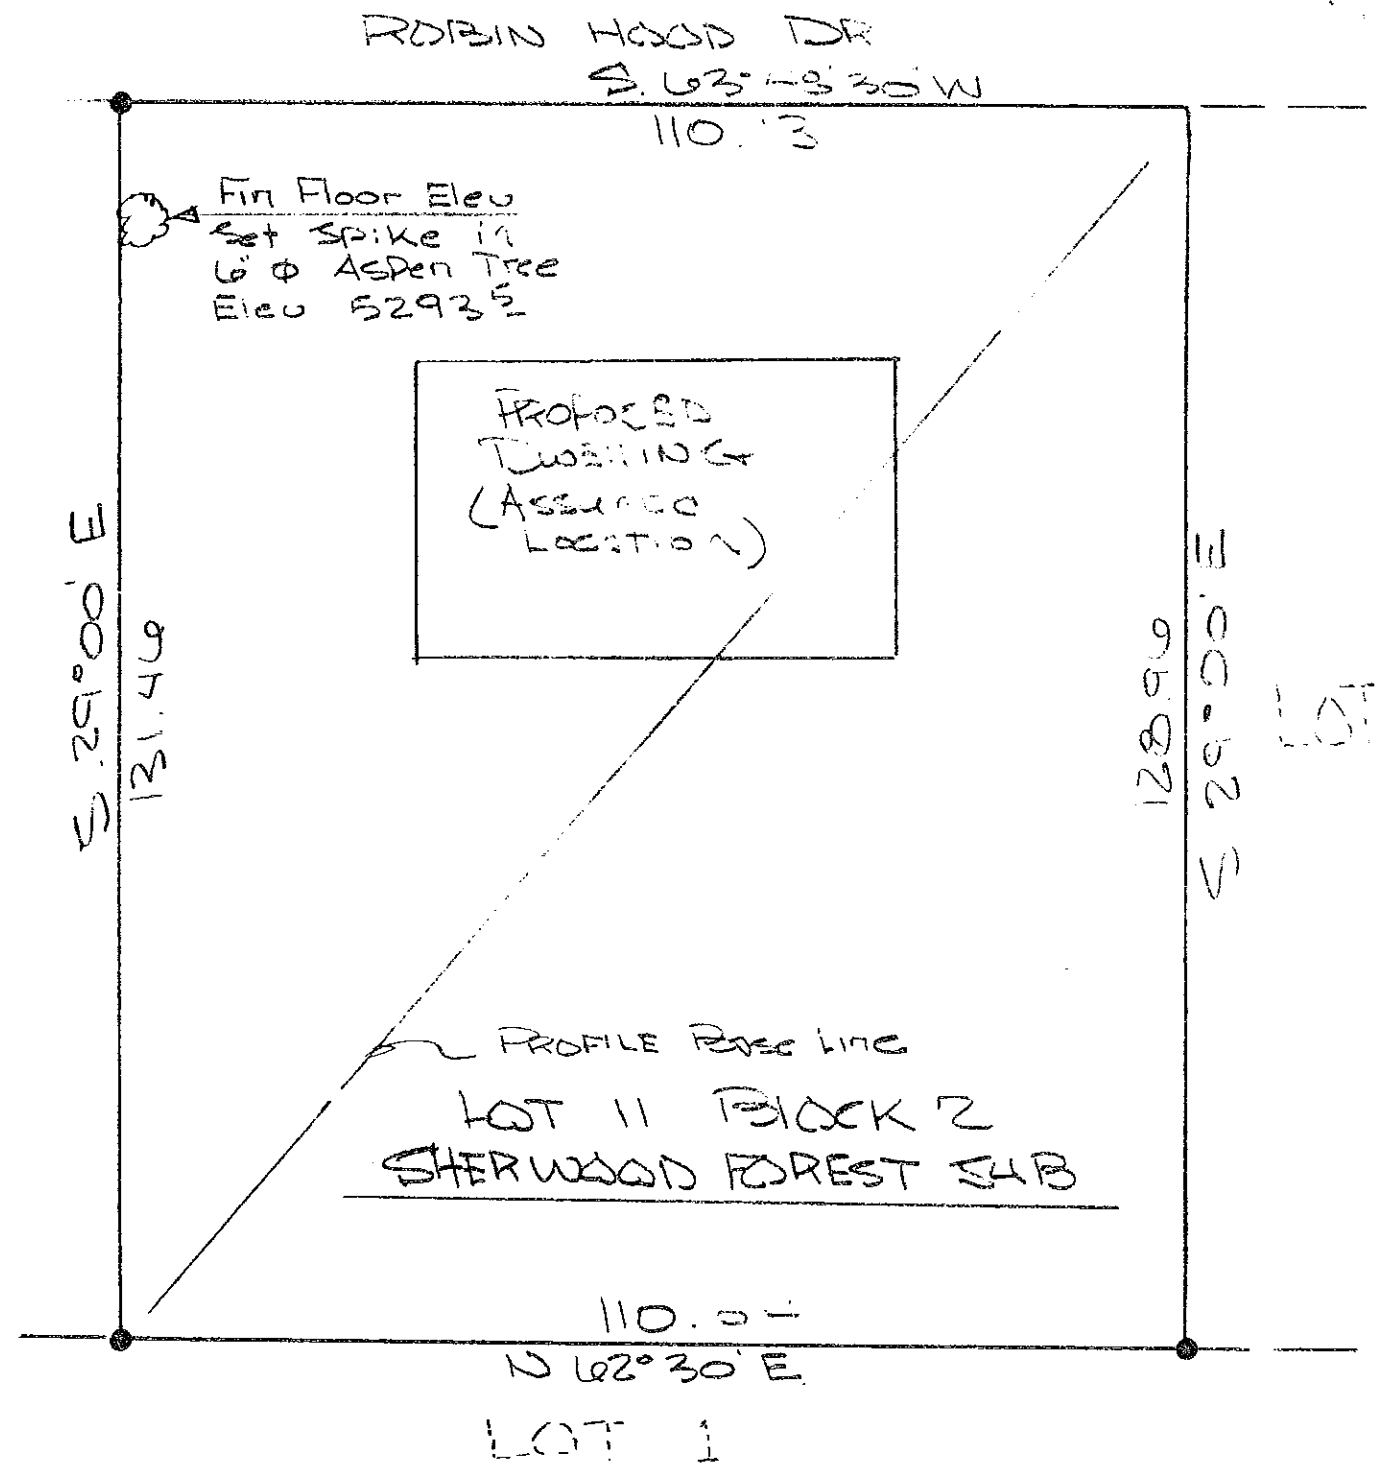

PLANS VIEW

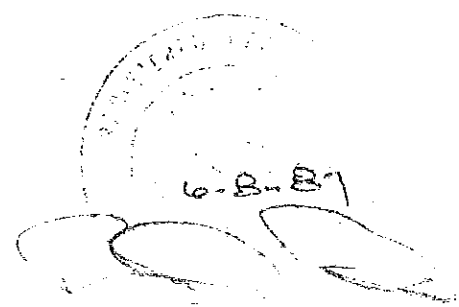

PLAN & PROFILE
 100 YR H.U.D. EL.
 FOR
 JOE YELDA
 ENGINEER

PUBLIC INFORMATION

ELEVATION CERTIFICATE
 FEDERAL EMERGENCY MANAGEMENT AGENCY
 NATIONAL FLOOD INSURANCE PROGRAM

O. M. B. No 3067-0077
 Expires May 31, 1993

ATTENTION: Use of this certificate does not provide a waiver of the flood insurance purchase requirement. This form is used only to provide elevation information necessary to ensure compliance with applicable community floodplain management ordinances, to determine the proper insurance premium rate, and/or to support a request for a Letter of Map Amendment or Revision (LOMA or LOMR). Instructions for completing this form can be found on the following pages.

SECTION A PROPERTY INFORMATION		FOR INSURANCE COMPANY USE
BUILDING OWNER'S NAME <u>JOE YELDA</u>		POLICY NUMBER
STREET ADDRESS (Including Apt., Unit, Suite and/or Bldg. Number) OR P.O. ROUTE AND BOX NUMBER <u>310 ROBINHOOD DR.</u>		COMPANY NAIC NUMBER
OTHER DESCRIPTION (Lot and Block Numbers, etc.) <u>LOT 11 BLOCK 2</u>		
CITY <u>HAILEY</u>	STATE <u>ID</u>	ZIP CODE <u>83333</u>

SECTION B FLOOD INSURANCE RATE MAP (FIRM) INFORMATION

Provide the following from the proper FIRM (See Instructions):

1. COMMUNITY NUMBER	2. PANEL NUMBER	3. SUFFIX	4. DATE OF FIRM INDEX	5. FIRM ZONE	6. BASE FLOOD ELEVATION (in AO Zones, use depth)
<u>160022</u>	<u>000</u>	<u>0</u>	<u>4/17/78</u>	<u>A-3</u>	<u>5292.5</u>

7. Indicate the elevation datum system used on the FIRM for Base Flood Elevations (BFE): NGVD '29 Other (describe on back)
 8. For Zones A or V, where no BFE is provided on the FIRM, and the community has established a BFE for this building site, indicate the community's BFE: feet NGVD (or other FIRM datum—see Section B, Item 7).

SECTION C BUILDING ELEVATION INFORMATION

- Using the Elevation Certificate Instructions, indicate the diagram number from the diagrams found on Pages 5 and 6 that best describes the subject building's reference level _____.
- FIRM Zones A1-A30, AE, AH, and A (with BFE). The top of the reference level floor from the selected diagram is at an elevation of 1529.15 feet NGVD (or other FIRM datum—see Section B, Item 7).
 - FIRM Zones V1-V30, VE, and V (with BFE). The bottom of the lowest horizontal structural member of the reference level from the selected diagram, is at an elevation of feet NGVD (or other FIRM datum—see Section B, Item 7).
 - FIRM Zone A (without BFE). The floor used as the reference level from the selected diagram is feet above or below (check one) the highest grade adjacent to the building.
 - FIRM Zone AO. The floor used as the reference level from the selected diagram is feet above or below (check one) the highest grade adjacent to the building. If no flood depth number is available, is the building's lowest floor (reference level) elevated in accordance with the community's floodplain management ordinance? Yes No Unknown
- Indicate the elevation datum system used in determining the above reference level elevations: NGVD '29 Other (describe under Comments on Page 2). (NOTE: If the elevation datum used in measuring the elevations is different than that used on the FIRM [see Section B, Item 7], then convert the elevations to the datum system used on the FIRM and show the conversion equation under Comments on Page 2.)
- Elevation reference mark used appears on FIRM: Yes No (See Instructions on Page 4)
- The reference level elevation is based on: actual construction construction drawings
 (NOTE: Use of construction drawings is only valid if the building does not yet have the reference level floor in place, in which case this certificate will only be valid for the building during the course of construction. A post-construction Elevation Certificate will be required once construction is complete.)
- The elevation of the lowest grade immediately adjacent to the building is: feet NGVD (or other FIRM datum—see Section B, Item 7).

SECTION D COMMUNITY INFORMATION

- If the community official responsible for verifying building elevations specifies that the reference level indicated in Section C, Item 1 is not the "lowest floor" as defined in the community's floodplain management ordinance, the elevation of the building's "lowest floor" as defined by the ordinance is: feet NGVD (or other FIRM datum—see Section B, Item 7).
- Date of the start of construction or substantial improvement _____.