

CITY OF HAILEY

FLOODPLAIN ELEVATION/FLOOD-PROOFING CERTIFICATION

This Certification must be signed and sealed by a registered professional engineer or ~~architect~~

1st Survey:

I hereby certify that the bench mark set on property identified as

T. S, R W, W.M., Section , Tax Lot

 is at an elevation of 5286⁵ feet, NGVD (Mean Sea Level)

Subdivision Birdwood

Lot 14 Block 1 Plat

Describe bench mark and its location:


Set spike in 16" cottonwood approximately 200' feet East from

West boundary of Lot 12, in center of Lot 12 1⁰⁰ above 100

year flood elevation = 5286⁵

SIGNATURE

Richard H. Carlson

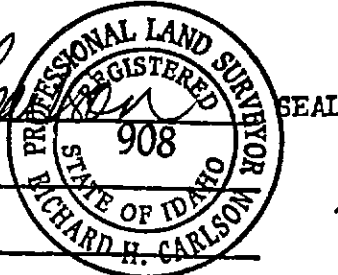

NAME Richard H. Carlson


TITLE Project Surveyor

ADDRESS P.O. Box 1066, Hailey, Idaho 83333

DATE August 1, 1990

This certification must be filed with the Hailey Building Department at the time of building permit application.

BM ELEVATION 5287.18'
TOP NUT FIRE HYDRANT


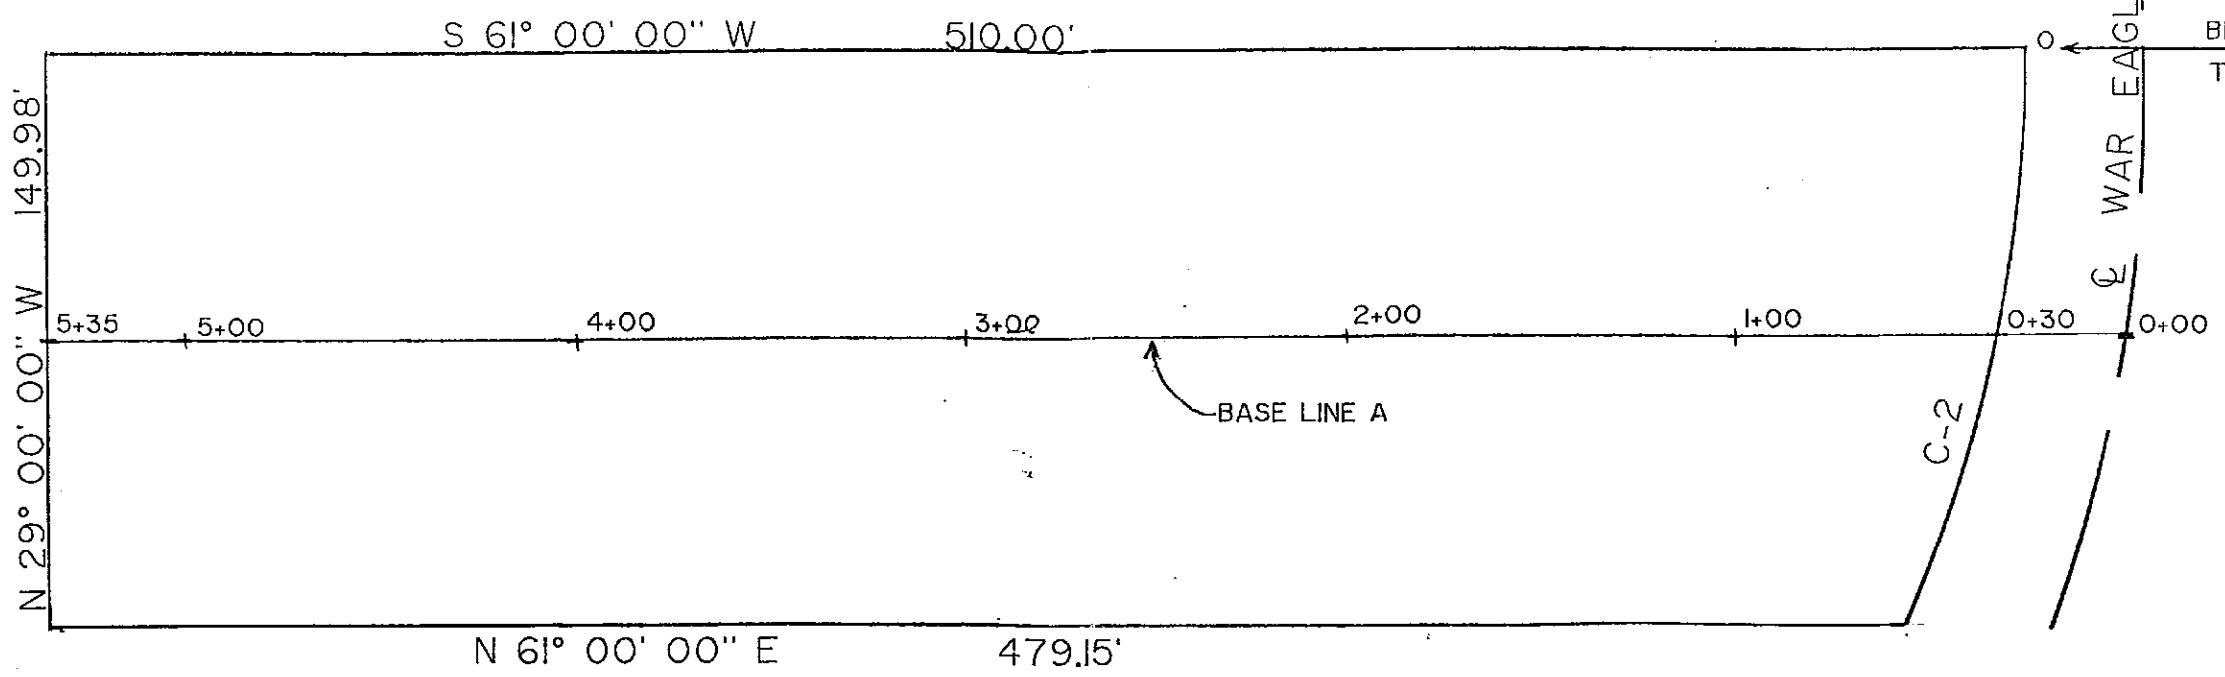


FLOOD CERT

OF
LOT 14 BLOCK I BIRDWOOD SUBD.
HAILEY, IDAHO
8/1/90

SCALE 1" = 50' HORZ.
1" = 2' VERT.

PLAN VIEW

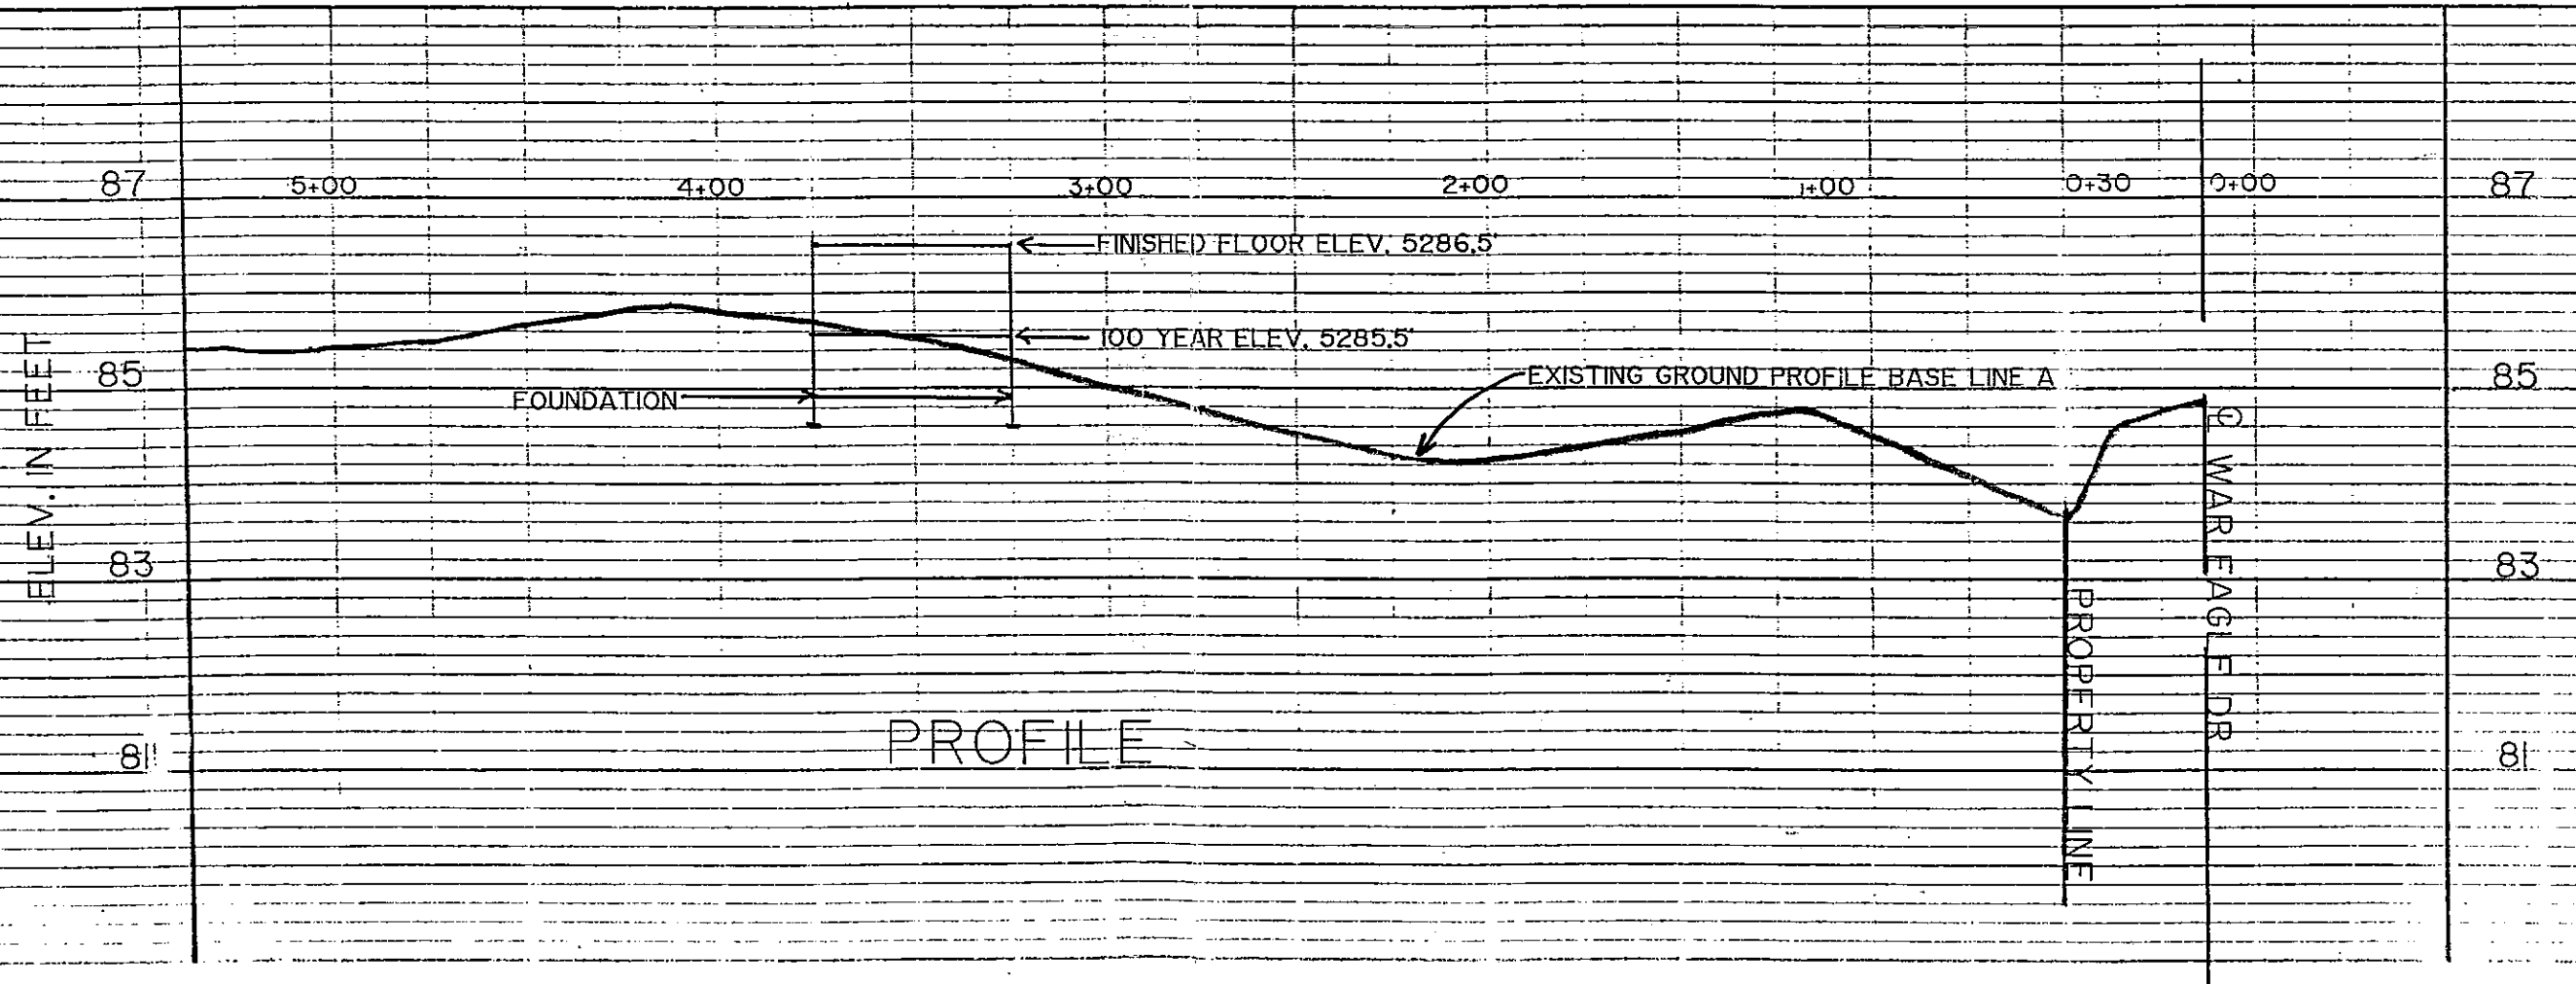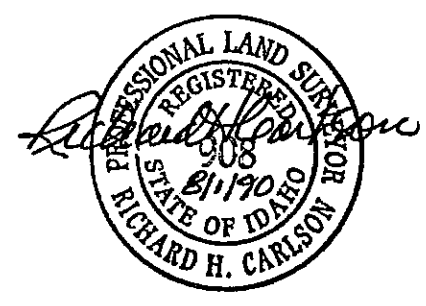

PROFILE

ELEVATION CERTIFICATE
FEDERAL EMERGENCY MANAGEMENT AGENCY
NATIONAL FLOOD INSURANCE PROGRAM

O.M.B. No 3067-0077
 Expires May 31, 1993

ATTENTION: Use of this certificate does not provide a waiver of the flood insurance purchase requirement. This form is used only to provide elevation information necessary to ensure compliance with applicable community floodplain management ordinances, to determine the proper insurance premium rate, and/or to support a request for a Letter of Map Amendment or Revision (LOMA or LOMR). Instructions for completing this form can be found on the following pages.

SECTION A PROPERTY INFORMATION		FOR INSURANCE COMPANY USE
BUILDING OWNER'S NAME		POLICY NUMBER
STREET ADDRESS (including Apt., Unit, Suite and or Bldg. Number) OR P.O. ROUTE AND BOX NUMBER		COMPANY NAIC NUMBER

OTHER DESCRIPTION (Lot and Block Numbers, etc.)
Lot 14 Bird Wood Sub.

CITY Hailey STATE Ida ZIP CODE 83333

SECTION B FLOOD INSURANCE RATE MAP (FIRM) INFORMATION

Provide the following from the proper FIRM (See Instructions):

1. COMMUNITY NUMBER	2. PANEL NUMBER	3. SUFFIX	4. DATE OF FIRM INDEX	5. FIRM ZONE	6. BASE FLOOD ELEVATION (in AC Zones, use depth)
<u>165167</u>	<u>0664</u>	<u>A</u>	<u>1981</u>	<u>A-2</u>	

7. Indicate the elevation datum system used on the FIRM for Base Flood Elevations (BFE): NGVD '29 Other (describe on back)
 B. For Zones A or V, where no BFE is provided on the FIRM, and the community has established a BFE for this building site, indicate the community's BFE: 11111 feet NGVD (or other FIRM datum—see Section E, Item 7).

SECTION C BUILDING ELEVATION INFORMATION

- Using the Elevation Certificate Instructions, indicate the diagram number from the diagrams found on Pages 5 and 6 that best describes the subject building's reference level: _____
- (a) FIRM Zones A1-A30, AE, AH, and A (with BFE). The top of the reference level floor from the selected diagram is at an elevation of 1522.8 feet NGVD (or other FIRM datum—see Section E, Item 7).
 (b) FIRM Zones V1-V30, VE, and V (with BFE). The bottom of the lowest horizontal structural member of the reference level from the selected diagram is at an elevation of 11111 feet NGVD (or other FIRM datum—see Section E, Item 7).
 (c) FIRM Zone A (without BFE). The floor used as the reference level from the selected diagram is _____ feet above _____ or below _____ (check one) the highest grade adjacent to the building.
 (d) FIRM Zone AD. The floor used as the reference level from the selected diagram is _____ feet above _____ or below _____ (check one) the highest grade adjacent to the building. If no flood depth number is available, is the building's lowest floor (reference level) elevated in accordance with the community's floodplain management ordinance? Yes No Unknown
- Indicate the elevation datum system used in determining the above reference level elevations: NGVD '29 Other (describe under Comments on Page 2). (NOTE: If the elevation datum used in measuring the elevations is different than that used on the FIRM [see Section E, Item 7], then convert the elevations to the datum system used on the FIRM and show the conversion equation under Comments on Page 2.)
- Elevation reference mark used appears on FIRM: Yes No (See Instructions on Page 4.)
- The reference level elevation is based on: actual construction construction drawings
 (NOTE: Use of construction drawings is only valid if the building does not yet have the reference level floor in place. In which case this certificate will only be valid for the building during the course of construction. A post-construction Elevation Certificate will be required once construction is complete.)
- The elevation of the lowest grade immediately adjacent to the building is: 1522.8 feet NGVD (or other FIRM datum—see Section E, Item 7).

SECTION D COMMUNITY INFORMATION

- If the community official responsible for verifying building elevations specifies that the reference level indicated in Section C, Item 1 is not the "lowest floor" as defined in the community's floodplain management ordinance, the elevation of the building's "lowest floor" as defined by the ordinance is: _____ feet NGVD (or other FIRM datum—see Section E, Item 7).
- Date of the start of construction or substantial improvement: _____

PUBLIC INFORMATION

SECTION E CERTIFICATION

This certification is to be signed by a land surveyor, engineer, or architect who is authorized by state or local law to certify elevation information when the elevation information for Zones A1-A30, AE, AH, A (with BFE), V1-V30, VE, and V (with BFE) is required. Community officials who are authorized by local law or ordinance to provide floodplain management information, may also sign the certification. In the case of Zones AO and A (without a FEMA or community issued BFE), a building official, a property owner, or an owner's representative may also sign the certification.


Reference level diagrams 6, 7 and 8 - Distinguishing Features--If the certifier is unable to certify to breakaway/non-breakaway wall, enclosure size, location of servicing equipment, area use, wall openings, or unfinished area Feature(s), then list the Feature(s) not included in the certification under Comments below. The diagram number, Section C, Item 1, must still be entered.

I certify that the information in Sections B and C on this certificate represents my best efforts to interpret the data available. I understand that any false statement may be punishable by fine or imprisonment under 18 U.S. Code, Section 1001.

CERTIFIER'S NAME Bruce T. Butler LICENSE NUMBER (or Affix Seal) PLS 907
 TITLE Surveyor COMPANY NAME Sawtooth Engineering
 ADDRESS P.O. 478 CITY Hayley STATE Ida ZIP 83333
 SIGNATURE _____ DATE 4-20-92 PHONE 788-9660

Copies should be made of this Certificate for: 1) community official, 2) insurance agent/company, and 3) building owner.

COMMENTS:

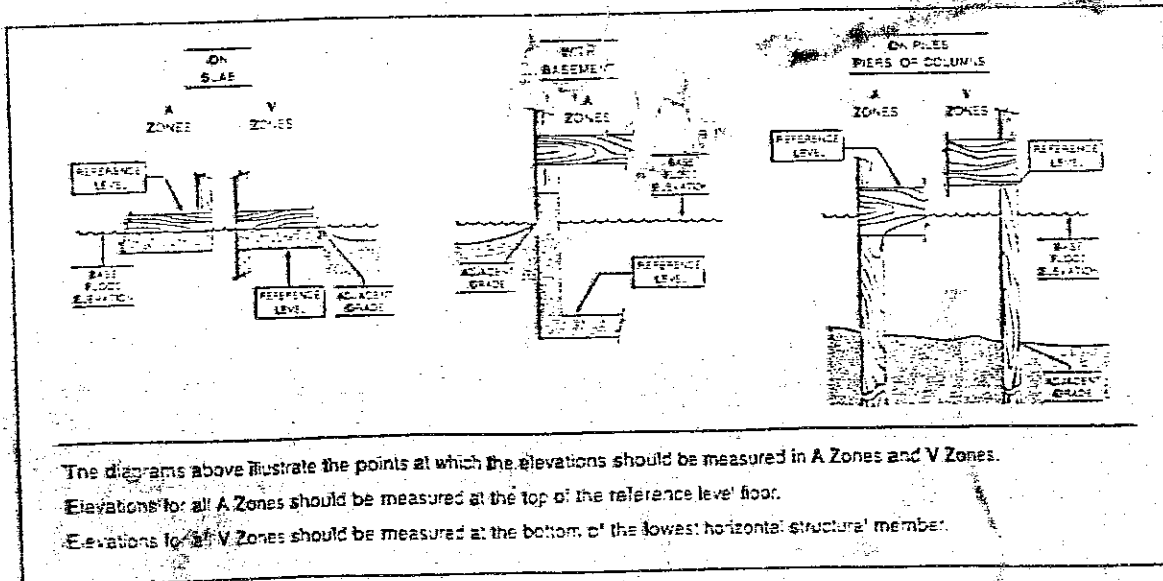

411 War Eagle

CITY OF HAILEY

FLOODPLAIN DEVELOPMENT PERMIT

Name of Applicant Terry Basolo Date 9-22-94
Name of Project if applicable _____
Address _____ Phone _____
Location of Proposed Development Subdivision Birdwood Lot 13
Block _____ Plat _____

Description of Development

- | | | |
|--|--|--|
| <input checked="" type="checkbox"/> Residential Construction | <input type="checkbox"/> Non-Residential | <input checked="" type="checkbox"/> New Construction |
| <input checked="" type="checkbox"/> On Single Lot | <input type="checkbox"/> Subdivision | <input type="checkbox"/> Excavation |
| <input type="checkbox"/> Addition or Improvements | <input type="checkbox"/> Fill | <input type="checkbox"/> Grading |
| <input type="checkbox"/> Watercourse Alteration | | |
| <input type="checkbox"/> Other _____ | | |

Attach to the application the following information where applicable. Plans in duplicate, drawn to scale showing the nature, dimensions, and elevations of the area in question; existing or proposed structures, fill, storage of materials, drainage facilities; and the location of the foregoing. Specifically, the following information is required: (1) Mean sea level (MSL) elevation of the lowest floor (including basement) of all structures; (2) MSL elevation to which any structure is floodproofed; (3) certification by a registered professional engineer that the floodproofing methods meet the community floodproofing criteria; (4) a description of the extent to which any watercourse will be altered or relocated, and (5) base (100-year) flood elevation data for a development or subdivision.


The proposed development is located in the Floodway Floodfringe
The Base Flood Elevation or depth number at the development site is: 5286

Source Documents FEMA

Plan Review

MSL Elevation or depth number to which the structure is to be elevated 5287 ft.
MSL Elevation or depth number to which the structure is to be floodproofed _____ ft.

SIGNATURE [Signature] (SEAL)
NAME Bruce T Butler
TITLE Surveyor
ADDRESS P.O. 478 Hailey

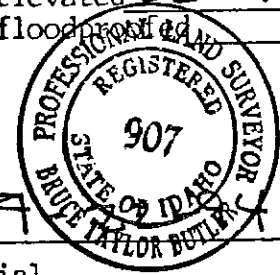

DATE 9

The following is to be completed by the community permit official
All necessary information and certificates are attached.

Action

- The proposed development is not in conformance with applicable Floodplain Management Standards (explanation attached). Permit is denied.
- The proposal is not in conformance with applicable Floodplain Management Standards (explanation attached) and the application is referred to the Board of Adjustment for variance action.
- I have reviewed the plans and materials submitted in support of the proposed development and find them in compliance with applicable Floodplain Management Standards. Permit is approved.

Date _____ Signature _____

Building construction documentation

The certified as-built MSL elevation of the lowest floor of the structure is _____ ft.
The certified as-built MSL floodproofed elevation of the structure is _____ ft.
Certificates of a registered professional engineer or land surveyor documenting these elevation are attached.
Certificate of Occupancy or Compliance Issued _____

Date _____ Signature _____

CITY OF HAILEY

FLOODPLAIN ELEVATION/FLOOD-PROOFING CERTIFICATION

This Certification must be signed and sealed by a registered professional engineer or ~~surveyor~~

1st Survey:

I hereby certify that the bench mark set on property identified as

T. _____ S. R. _____ W. W.M., Section _____, Tax Lot

_____ is at an elevation of 5287⁰ feet, NGVD (Mean Sea Level)

Subdivision Birdwood

Lot 13 Block 1 Plat _____

Describe bench mark and its location: _____

Set spike in 20" ϕ Aspen Tree
approx. 73' W. & 130' N of SE
corner of Lot 13 Birdwood

SIGNATURE *Bruce T. Butler*


SEAL

NAME Bruce T. Butler

TITLE Surveyor

ADDRESS P.O. 478

DATE 9-22-94

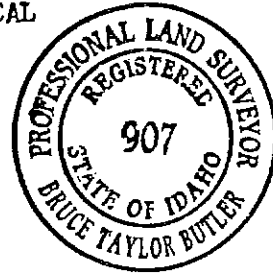

This certification must be filed with the Hailey Building Department at the time of building permit application.

